



ADDENDUM NO. 2
TO THE
CONTRACT DOCUMENTS
FOR

RFP#2325-04 TURNKEY POLE STORAGE BUILDING

January 18, 2024

To ALL Planholders:

The following changes, additions and/or deletions are hereby made a part of the Contract Documents as fully and completely as if the same were fully set forth therein:

- **The Proposal Submission Deadline shall be extended to Thursday, February 1st, 2024 at 2:00pm PST local time.**
- **Utility As-Builts provided in supporting documents and attached to this addendum.**
- **Document labeled “RFP 2325-04 Engineers Drawings” will be replaced by “RFP 2325-04 Engineers Drawings – Corrected” and is attached to this addendum.**
- **Adding document labeled “RFP 2325-04 Structural Calculations” - attached to this addendum.**

All bidders shall acknowledge receipt and acceptance of this Addendum No. 1 by signing in the space provided and submitting the signed Addendum with the Bid. Bids

submitted without this Addendum will be considered informal.

Receipt acknowledged and conditions agreed to this _____ day of _____, 2024.

Bidder _____

By _____

RFP 2325-04 Utility As Builts



Benton County
Public Works Department
360 SW Avery Avenue
Corvallis, Oregon 97333
Phone: 541-766-6821
FAX: 541-766-6891

Date:
25 July, 2011

Renewal Date:

**BENTON COUNTY FAIR GROUNDS
UTILITY AS-BUILTS**

TL 300, 11S, R6W, SECTION 32

TELECOMM SYSTEMS

Revision Description	Date	Initials
MODIFIED SEWER	12-31-11	APM
MOD TELECOM	3-09-09	APM
MODIFIED POWER	9-26-02	APM
MODIFIED WATER	12-31-11	APM
MODIFIED STORM	12-31-11	APM

Scale: **1" = 60'**

Drawn by: APM
Designed by: APM


Project #: **B-25-01-08**

File Location:
G:\Avery Proj\Mgmt\OtherDepts\Fairgrounds

Index Number:
U-1.1

Sheet # **1** of **8** Sheets

LEGEND	
TELE-LINE	— ETL —
TELE-POINT	■

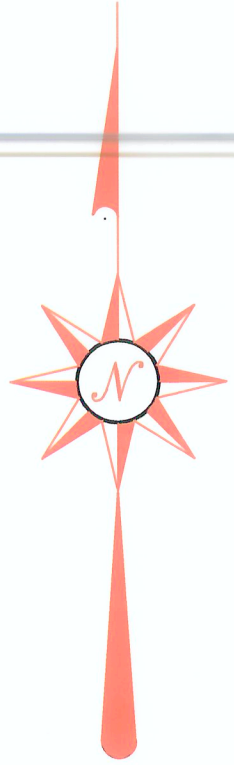

Benton County
Public Works Department
360 SW Avery Avenue
Corvallis, Oregon 97333
Phone: 541-766-6321
FAX: 541-766-6891

Date:
26 July, 2011

Renewal Date:

**BENTON COUNTY FAIR GROUNDS
UTILITY AS-BUILTS**

TL 300, 115, RW, SECTION 32

POWER

Revision Description	Date	Initials
MODIFIED SEWER	12-31-11	APM
MOD TELECOM	9-20-02	APM
MODIFIED POWER	12-10-2012	APM
MODIFIED WATER	12-31-11	APM
MODIFIED STORM	12-31-11	APM

Scale: **1" = 60'**

Drawn by: APM Designed by: APM

Project #: **B-25-01-08**

File Location: G:\Avery Proj\Mgmt\OtherDepts\Fairgrounds


Index Number:
U-1.2

Sheet # **2** of **8** Sheets

LEGEND	
POWERLINE	— P —
POWER POINT	■
POWER POLE	○
SIGN BOARD	⊠



LEGEND	
SEWERLINE	
SS MANHOLE	
SS CLEANOUT	
WASH RACK	
RV HOOKUP	

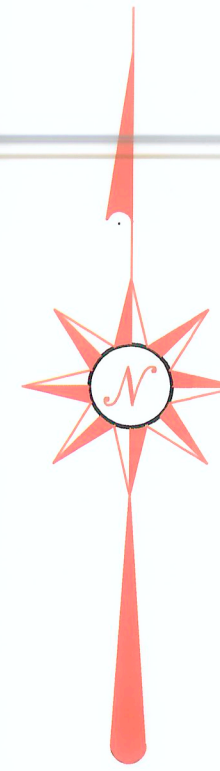

Benton County
Public Works Department
360 SW Avery Avenue
Corvallis, Oregon 97333
Phone: 541-766-6821
FAX: 541-766-6891

Date:
26 July, 2011

Renewal Date:

BENTON COUNTY FAIR GROUNDS UTILITY AS-BUILTS

TL 300, 11S, RBW, SECTION 32

SEWER SYSTEM

Revision Description	Date	Initials
MODIFIED SEWER	07-11-13	HGJ
MOD TELECOM	9-20-02	APM
MODIFIED POWER	9-26-02	APM
MODIFIED WATER	12-31-11	APM
MODIFIED STORM	12-31-11	APM

Scale: **1" = 60'**

Drawn by: APM Designed by: APM

Project #: **B-25-01-08**

File Location:
G:\Avery Proj\Mgmt\OtherDepts\Fairgrounds

Index Number:

4C-1.3

Sheet # **3** of **8** Sheets