

Benton County
Public Works Department
360 SW Avery Avenue
Corvallis, Oregon 97333
Phone: 541-766-6821
FAX: 541-766-6891

Date:
25 July, 2011

**BENTON COUNTY FAIR GROUNDS
UTILITY AS-BUILTS**

TL 300, 11S, RW, SECTION 32 - 63rd Street

WATER SYSTEM

| Revision Description | Date | Initials |
|----------------------|----------|----------|
| MOD IRRIGATION | 7-8-2013 | HGJ |
| MODIFIED SEWER | 12-31-11 | APM |
| NEW TRENCH DTL | 9-26-02 | GPK |
| MODIFIED WATER | 07-11-14 | HGJ |
| MODIFIED STORM | 12-31-11 | APM |

Scale: **1" = 60'**

Drawn by: APM Designed by:

Project #:


File Location:
G:\Avery Proj\Mgmt\OtherDepts\Fairgrounds

Index Number:

C-1.4

Sheet # **4** of **8** Sheets

| LEGEND | |
|--------------|--|
| WATERLINE | |
| WATER METER | |
| WATER VALVE | |
| FIRE HYDRANT | |

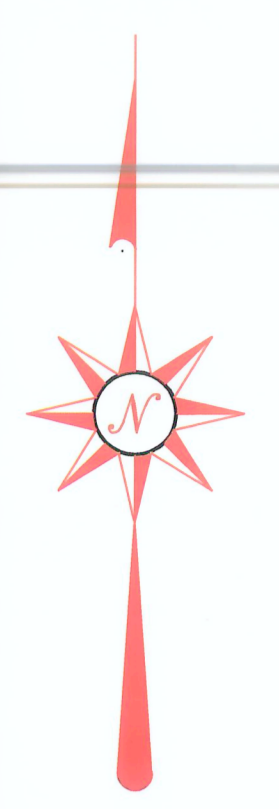

Benton County
Public Works Department
360 SW Avery Avenue
Corvallis, Oregon 97333
Phone: 541-766-6821
FAX: 541-766-6891

Date:
26 July, 2011

**BENTON COUNTY FAIR GROUNDS
UTILITY AS-BUILTS
IRRIGATION SYSTEM**

TL 300, 11S, R&W, SECTION 32 - 53rd Street

| Revision Description | Date | Initials |
|----------------------|----------|----------|
| MOD IRRIGATION | 6-27-14 | HGJ |
| MODIFIED SEWER | 12-31-11 | APM |
| NEW TRENCH DTL | 9-26-02 | GPK |
| MODIFIED WATER | 12-31-11 | APM |
| MODIFIED STORM | 12-31-11 | APM |

Scale: **1" = 60'**

Drawn by: APM Designed by:

Project #:

File Location:
G:\Avery Proj\Mgmt\OtherDepts\Fairgrounds

Index Number:


U-1.5

Sheet # **5** of **8** Sheets

| LEGEND | |
|-----------------|--|
| IRRIGATION LINE | |
| IRR-BALL VALVE | |
| IRR_TWIST LOCK | |
| IRR- VALVE BOX | |
| STAND PIPE | |
| IRR-HORSE BIB | |
| YARD HYDRANT | |



| LEGEND | |
|-----------|--|
| GAS LINE | |
| GAS POINT | |

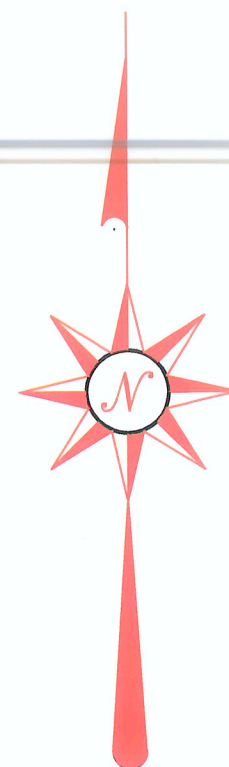

Benton County
Public Works Department
380 SW Avery Avenue
Corvallis, Oregon 97333
Phone: 541-766-6521
FAX: 541-766-6891

Date:
26 July, 2011

Renewal Date:
6/30/03

**BENTON COUNTY FAIR GROUNDS
UTILITY AS-BUILTS**

TL 300, 11S, R/W, SECTION 32 - 53rd Street

GASLINES

| Revision Description | Date | Initials |
|----------------------|----------|----------|
| MODIFIED SEWER | 9-16-02 | GPK |
| MODIFIED SEWER | 12-31-11 | APM |
| MODIFIED GAS | 3-09-09 | APM |
| MODIFIED WATER | 12-31-11 | APM |
| MODIFIED STORM | 12-31-11 | APM |

Scale: **1" = 60'**

Drawn by: APM
Designed by:

Project #: **B-25**

File Location:
G:\Avery ProjMgmt\OtherDepts\Fairgrounds

Index Number:
U-1.6

Sheet # **6** of **8** Sheets