




LEGEND	
TELE-LINE	
TELE-POINT	

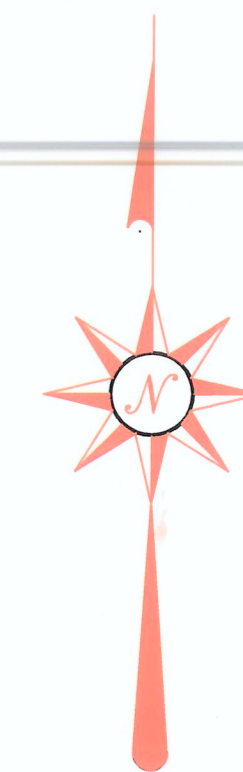

Benton County  
Public Works Department  
360 SW Avery Avenue  
Corvallis, Oregon 97333  
Phone: 541-766-6821  
FAX: 541-766-6891

Date:  
**25 July, 2011**

Renewal Date:

**BENTON COUNTY FAIR GROUNDS  
UTILITY AS-BUILTS**

TL 300, 11S, RBW, SECTION 32

**TELECOMM SYSTEMS**

Revision Description	Date	Initials
MODIFIED SEWER	12-31-11	APM
MOD TELECOM	3-09-09	APM
MODIFIED POWER	9-26-02	APM
MODIFIED WATER	12-31-11	APM
MODIFIED STORM	12-31-11	APM

Scale: **1" = 60'**


Drawn by: APM      Designed by: APM

Project #: **B-25-01-08**

File Location:  
G:\Avery Proj\Mgmt\OtherDepts\Fairgrounds

Index Number:  
**U-1.1**

Sheet # **1** of **8** Sheets

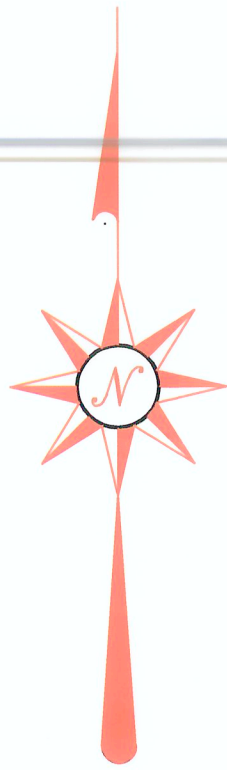

Benton County  
Public Works Department  
360 SW Avery Avenue  
Corvallis, Oregon 97333  
Phone: 541-766-6321  
FAX: 541-766-6891

Date:  
**26 July, 2011**

Renewal Date:

**BENTON COUNTY FAIR GROUNDS  
UTILITY AS-BUILTS**

TL 300, 115, RW, SECTION 32

**POWER**

Revision Description	Date	Initials
MODIFIED SEWER	12-31-11	APM
MOD TELECOM	9-20-02	APM
MODIFIED POWER	12-10-2012	APM
MODIFIED WATER	12-31-11	APM
MODIFIED STORM	12-31-11	APM

Scale: **1" = 60'**

Drawn by: APM      Designed by: APM


Project #: **B-25-01-08**

File Location: G:\Avery Proj\Mgmt\OtherDepts\Fairgrounds

Index Number:  
**U-1.2**

Sheet # **2** of **8** Sheets

LEGEND	
POWERLINE	— P —
POWER POINT	■
POWER POLE	○
SIGN BOARD	⊠

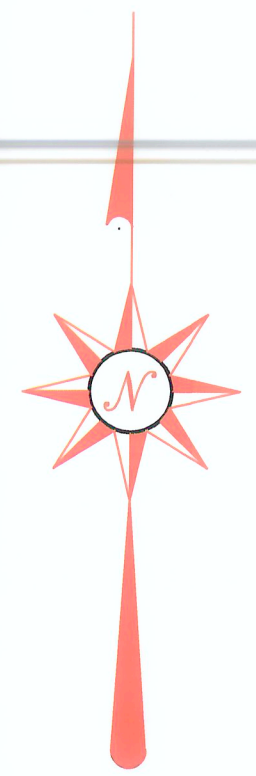

Benton County  
Public Works Department  
360 SW Avery Avenue  
Corvallis, Oregon 97333  
Phone: 541-766-6821  
FAX: 541-766-6891

Date:  
**26 July, 2011**

Renewal Date:

**BENTON COUNTY FAIR GROUNDS  
UTILITY AS-BUILTS  
SEWER SYSTEM**

TL 300, 11S, RBW, SECTION 32

Revision Description	Date	Initials
MODIFIED SEWER	07-11-13	HGJ
MOD TELECOM	9-20-02	APM
MODIFIED POWER	9-26-02	APM
MODIFIED WATER	12-31-11	APM
MODIFIED STORM	12-31-11	APM

Scale: **1" = 60'**

Drawn by: APM      Designed by: APM

Project #: **B-25-01-08**

File Location:  
G:\Avery Proj\Mgmt\OtherDepts\Fairgrounds

Index Number:  
**4C-1.3**

Sheet # **3** of **8** Sheets

SEWERLINE	
SS MANHOLE	
SS CLEANOUT	
WASH RACK	
RV HOOKUP	