




*Revised during call from Project 10-25-16*

LEGEND	
STORM LINE	---
SD MANHOLE	○
SD CATCH BASIN	⊗
CURB INLET	⊞
FIELD INLET	⊞

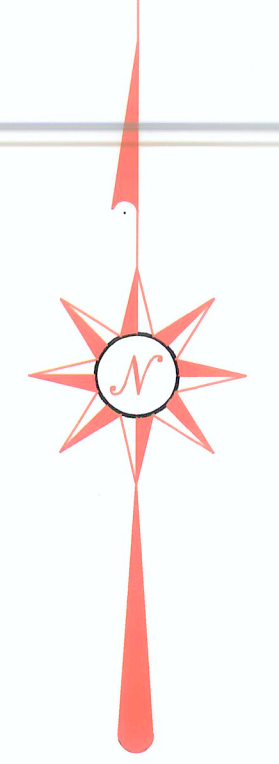

**Benton County**  
 Public Works Department  
 360 SW Avery Avenue  
 Corvallis, Oregon 97333  
 Phone: 541-766-6821  
 FAX: 541-766-6891

Date:  
**26 July, 2011**

Renewal Date:

**BENTON COUNTY FAIR GROUNDS  
 UTILITY AS-BUILTS  
 STORM DRAIN SYSTEM**

TL 300, 11S, RBW, SECTION 32 - 53rd Street

Revision Description	Date	Initials
<b>MODIFIED STORM</b>	<b>10-17-12</b>	<b>APM</b>

Scale: **1" = 60'**


Drawn by: **APM**      Designed by: **APM**

Project #: **B-25**

File Location: **G:\Avery Proj\Mgmt\OtherDepts\Fairgrounds**

Index Number:  
**U-1.7**  
 Sheet # **7** of **8** Sheets

LEGEND	
STORM LINE	
SD MANHOLE	
SD CATCH BASIN	
CURB INLET	
FIELD INLET	
SEWERLINE	
SS MANHOLE	
SS CLEANOUT	
WASH RACK	
RV HOOKUP	
WATERLINE	
WATER METER	
WATER VALVE	
FIRE HYDRANT	
IRRIGATION LINE	
IRR-BALL VALVE	
IRR_TWIST LOCK	
IRR- VALVE BOX	
STAND PIPE	
IRR-HORSE BIB	
GAS LINE	
GAS POINT	
POWERLINE	
POWER POINT	
POWER POLE	
SIGN BOARD	
TELE-LINE	
TELE-POINT	

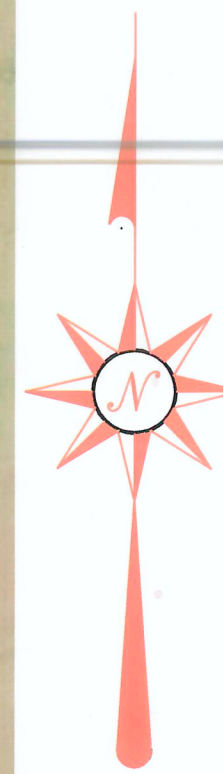

Benton County  
Public Works Department  
360 SW Avery Avenue  
Corvallis, Oregon 97333  
Phone: 541-766-8921  
FAX: 541-766-6891

Date:  
**13 October, 2010**

Renewal Date:

**BENTON COUNTY FAIR GROUNDS  
UTILITY AS-BUILTS**

TL 300, 11S, ROW, SECTION 32 - 53rd Street

**UTILITY SYSTEMS**

Revision Description	Initials	Date
MODIFIED STORM	APM	10-13-10
Scale:	<b>1" = 60'</b>	
Drawn by:	Designed by:	
APM	APM	
Project #:	<b>B-25</b>	
File Location:	G:\Avery Proj\Mgmt\OtherDepts\Fairgrounds	
Index Number:	<b>U-1.8</b>	
Sheet #	8 of 8 Sheets	